

PLAN OF SURVEY


BANKSIA ESTATE

OFFICER

SCALE 1:1000 (A3)

I Benjamin S. Nobelius L.S. certify the levels shown in this plan are to A.H.D. based on Pakenham PM 183 (R.L. 34.73m)

RIX ROAD

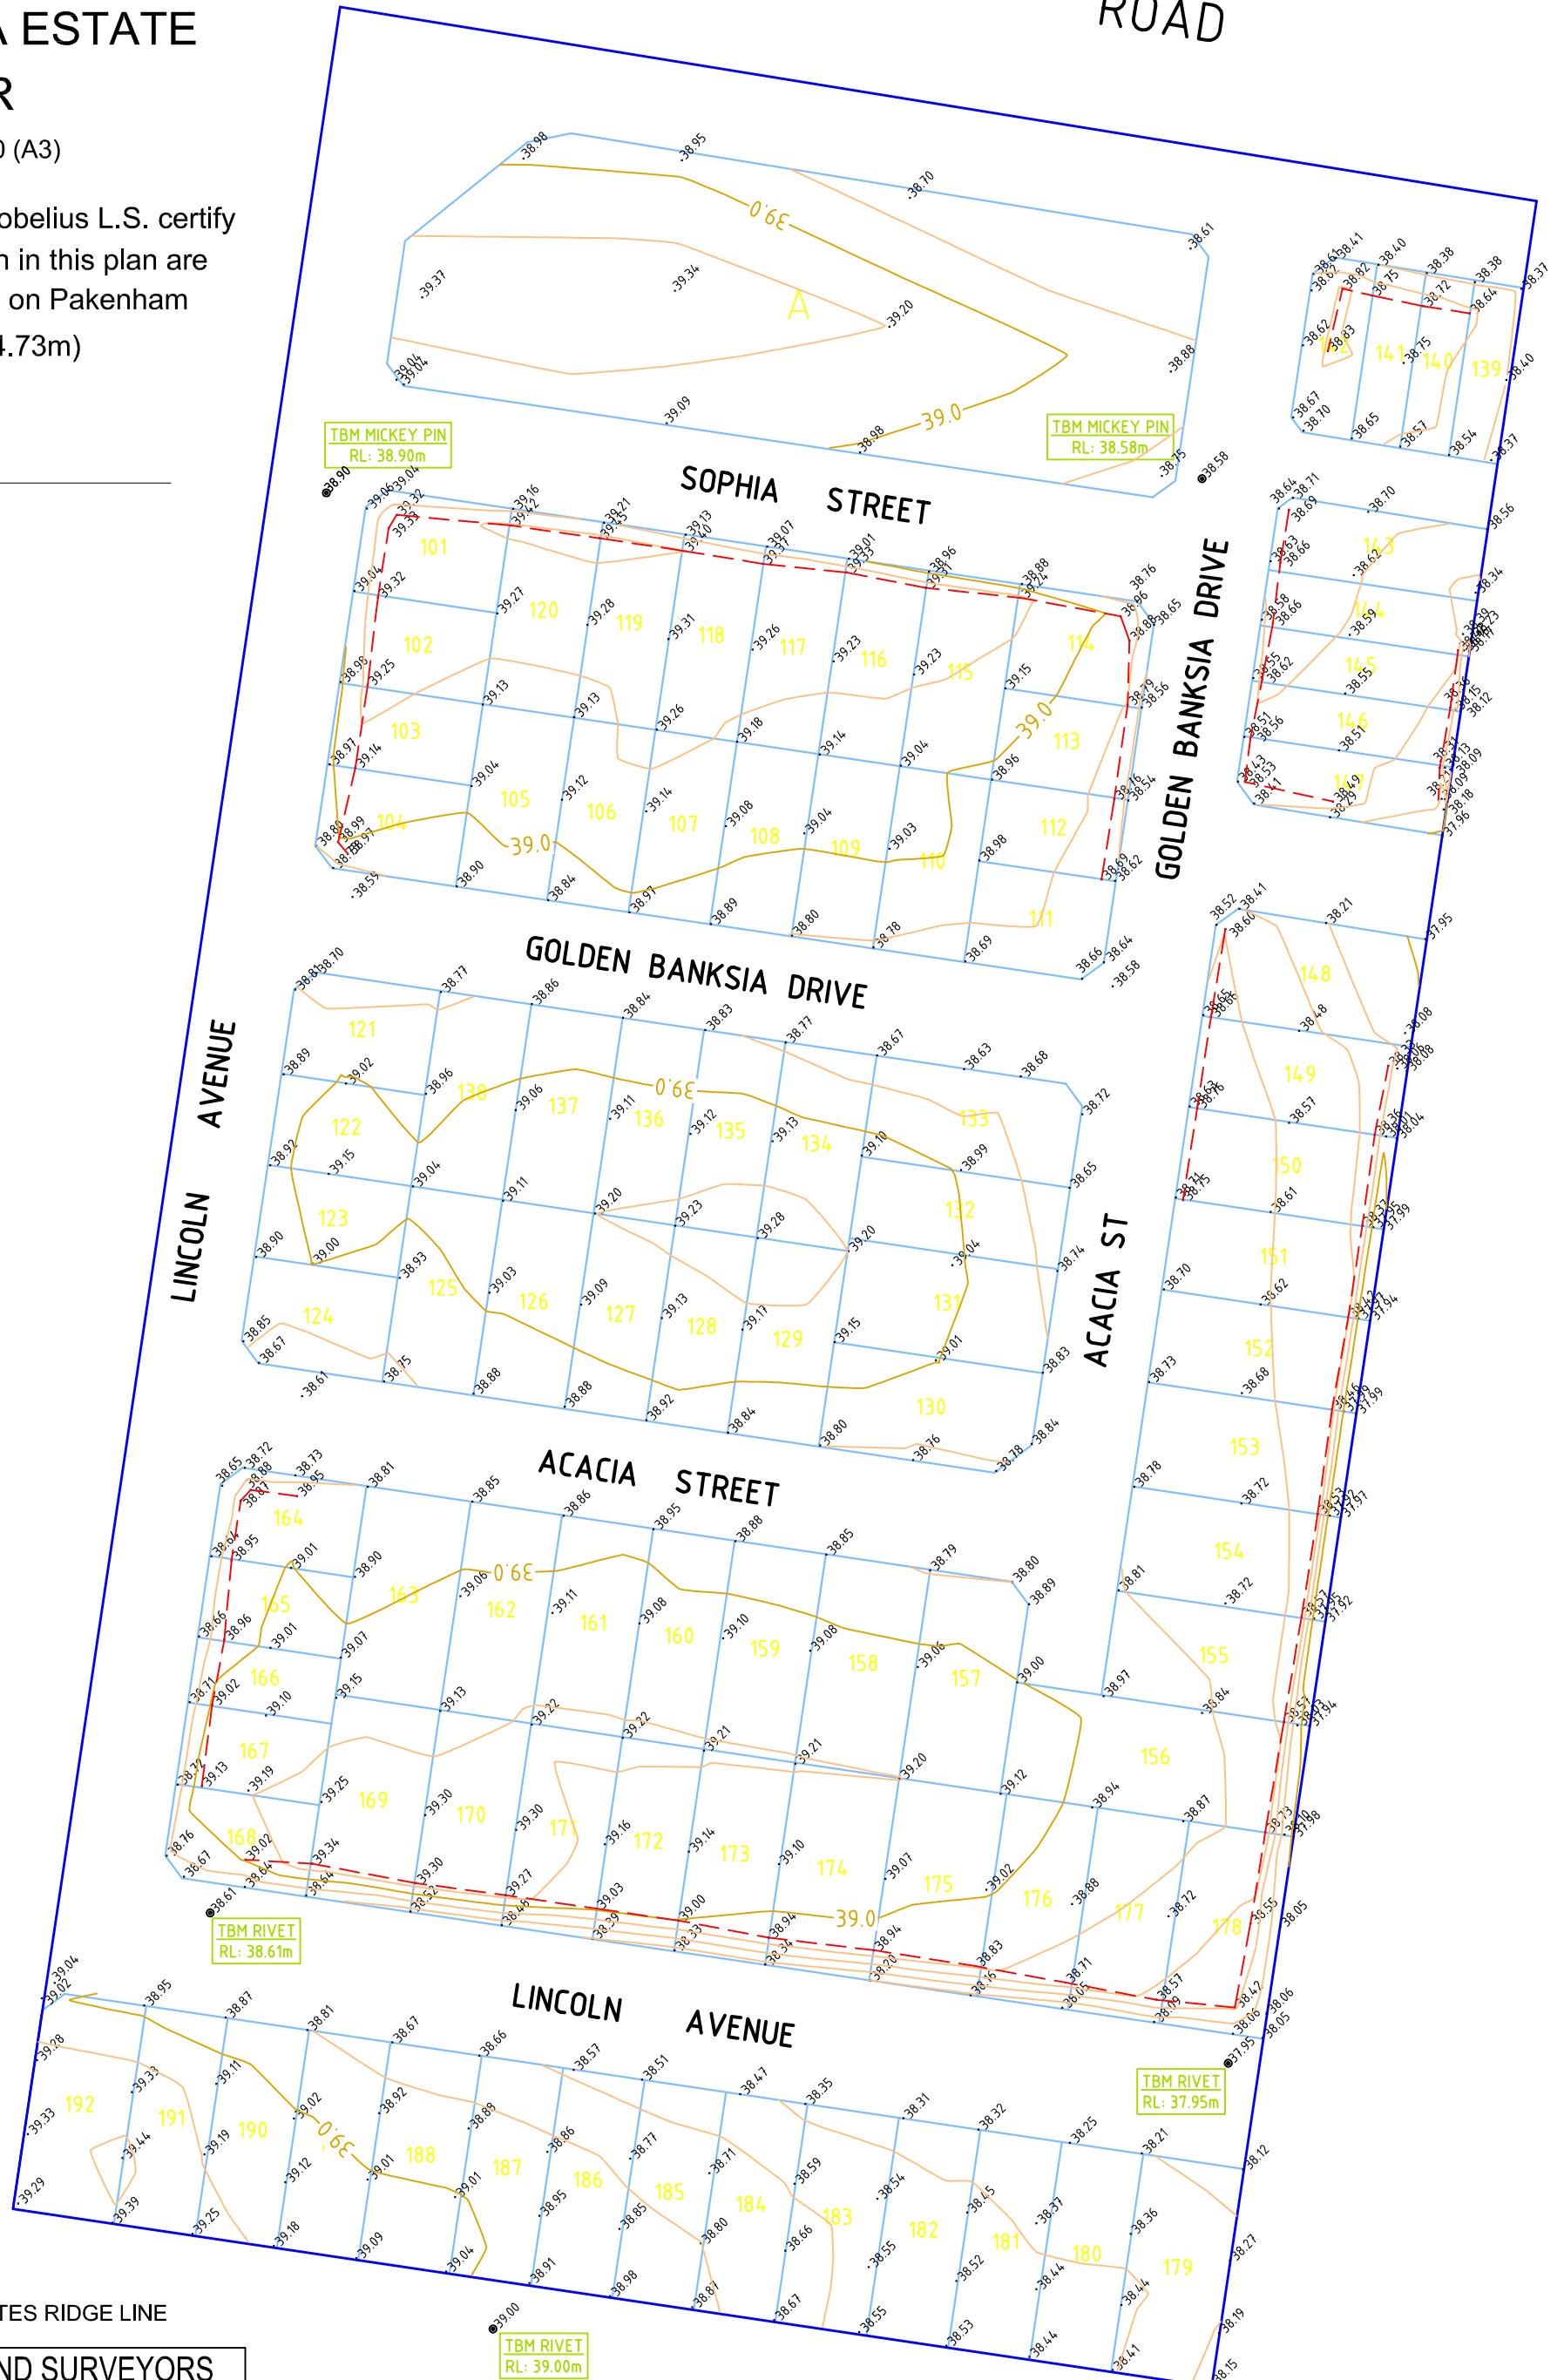

--- DENOTES RIDGE LINE

NOBELIUS LAND SURVEYORS

P.O. BOX 461
PAKENHAM 3810
Ph 03 5941 4112
Fax 03 5941 7359
rob@nobelius.com.au



OFFICER SERVICE STATION REAR CARPARK

DRAWN BY : M.NOBELIUS
DATE OF SURVEY : 26/04/2018
SURV. REF. NO. 10599